

Status B
Submittal was reviewed for design conformity and general conformance with the design intent only within the remit of an architect. The sub-contractor is responsible for confirming and correlating dimensions at job sites for tolerances, clearances, quantities, fabrication processes and techniques of construction, safety, coordination of his work with other trades and full compliance with the contract documents. The review shall not be construed to mean acceptance of the detail design inherent in the drawing, responsibility for which will remain with the sub-contractor. The sub-contractor is responsible for any errors or omissions in the drawing and for meeting all the requirements of the contract documents or otherwise.
Conran and Partners 06/07/16

C&P reserve the right to add additional comments to these drawings at a later stage as these drawings were submitted for review, prior to formally agreed C&P design period. As such C&P have not commenced works on the areas related to these drawings and cannot review and comment in full.

DOCUMENT REVIEW

Brookfield MULTIPLEX

BM

BROOKFIELD MULTIPLEX STATUS

A No Comment

B Noted subject to comments; correct and resubmit within 5 Business Days

C Rejected – correct and resubmit within 5 Business Days

BMCE CHECKED BY:

Adrian Dunnett

DATE:

19/07/2016


Incorporate comments and resubmit drawing following release of Level 33/34 survey and architectural 'For Construction' issue drawings.

M&E subcontractor to confirm spatial fit of all M&E equipment

Sweco- Status B
07-07-2016
K.Shoda

NOTE: -
1. HOLE FOR WASTE FROM WHB THROUGH VANITY UNIT TO BE COORDINATED WITH SERVICE INSTALLATION
2. HOLES FOR HOT & COLD WATER SERVICES REQUIRED. THIS WILL ALSO NEED TO BE COORDINATED WITH OTHER SERVICES AND PENETRATION REQUIREMENT
3. PLEASE REFER TODRG- E1003-81-CPT-XX-127 REV 01 FOR OTHER COMMENTS

See comment on drawing 81-CPT-XX-142

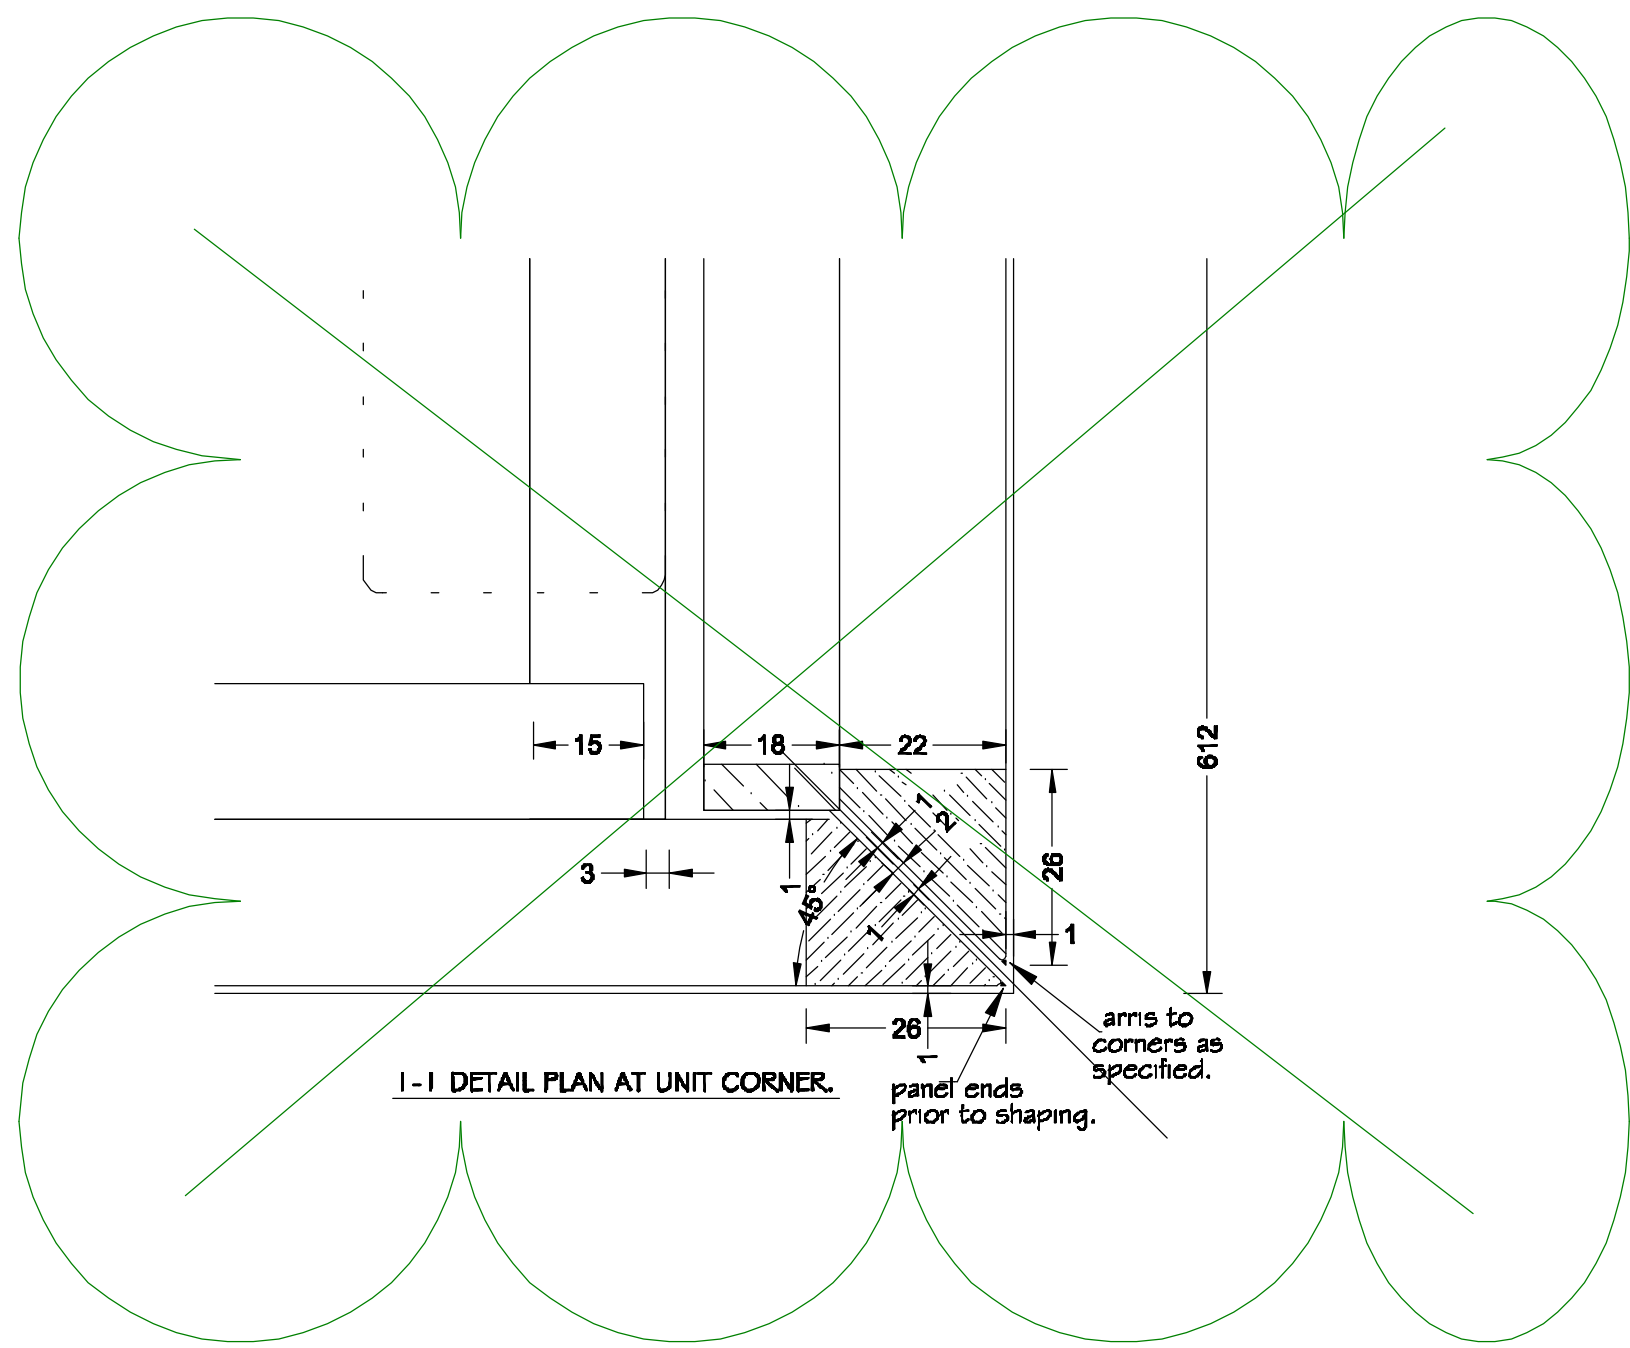

READ WITH E1003-81-CPT-XX-146 & 147

FOR INFORMATION	FOR APPROVAL	FOR CONSTRUCTION
DO NOT SCALE		
REV		
DATE		
BY		
DESCRIPTION		
DIMENSIONS TO BE VERIFIED ON SITE.		
FIGURE DIMENSIONS TO BE TAKEN IN PREFERENCE TO THOSE SCALE.		
THIS DRAWING IS THE PROPERTY OF JMS SPECIALIST JOINERY LTD.		
COPYRIGHT IS RESERVED BY JMS AND THE DRAWING IS LOANED ON THE CONDITION THAT IT IS NOT TO BE REPRODUCED OR TRANSMITTED IN ANY FORM OR BY ANY MEANS, ELECTRONIC OR MECHANICAL, INCLUDING PHOTOCOPYING, RECORDING, OR BY ANY INFORMATION STORAGE AND RETRIEVAL SYSTEM, WITHOUT THE WRITTEN CONSENT OF JMS SPECIALIST JOINERY LTD.		
<div><div>JMS</div><div>SPECIALIST JOINERY LTD</div></div>		
UNIT 8, BOURNE END KINGTON ROAD INDUSTRIAL ESTATE SOUTHAM CV47 0NA TELEPHONE: 01926 813813 FAX: 01926 812777 E-MAIL: admin@jmsjoineryltd.co.uk		
CLIENT RAPHAEL CONTRACTING LTD		
PROJECT CENTRE POINT, 103 NEW OXFORD ST.		
SCALE 1:10, 1:5 & 1:1.		
DATE 20-10-2015		
DRAWN BY AJG		
CHECKED BY		
DRAWING TITLE Apartment type 8, Penthouse Bathroom Type 1 Room 1.9 Vanity Unit Type C2, level 34.		
PROJECT No 6538		
REVISION		
DRAWING No E1003-81-CPT-XX-145		
DRAWING STATUS FOR APPROVAL		