


POSITION OF
NEW TRANSFER
STRUCTURE TBC
FOLLOWING
AGREEMENT
WITH UKPN

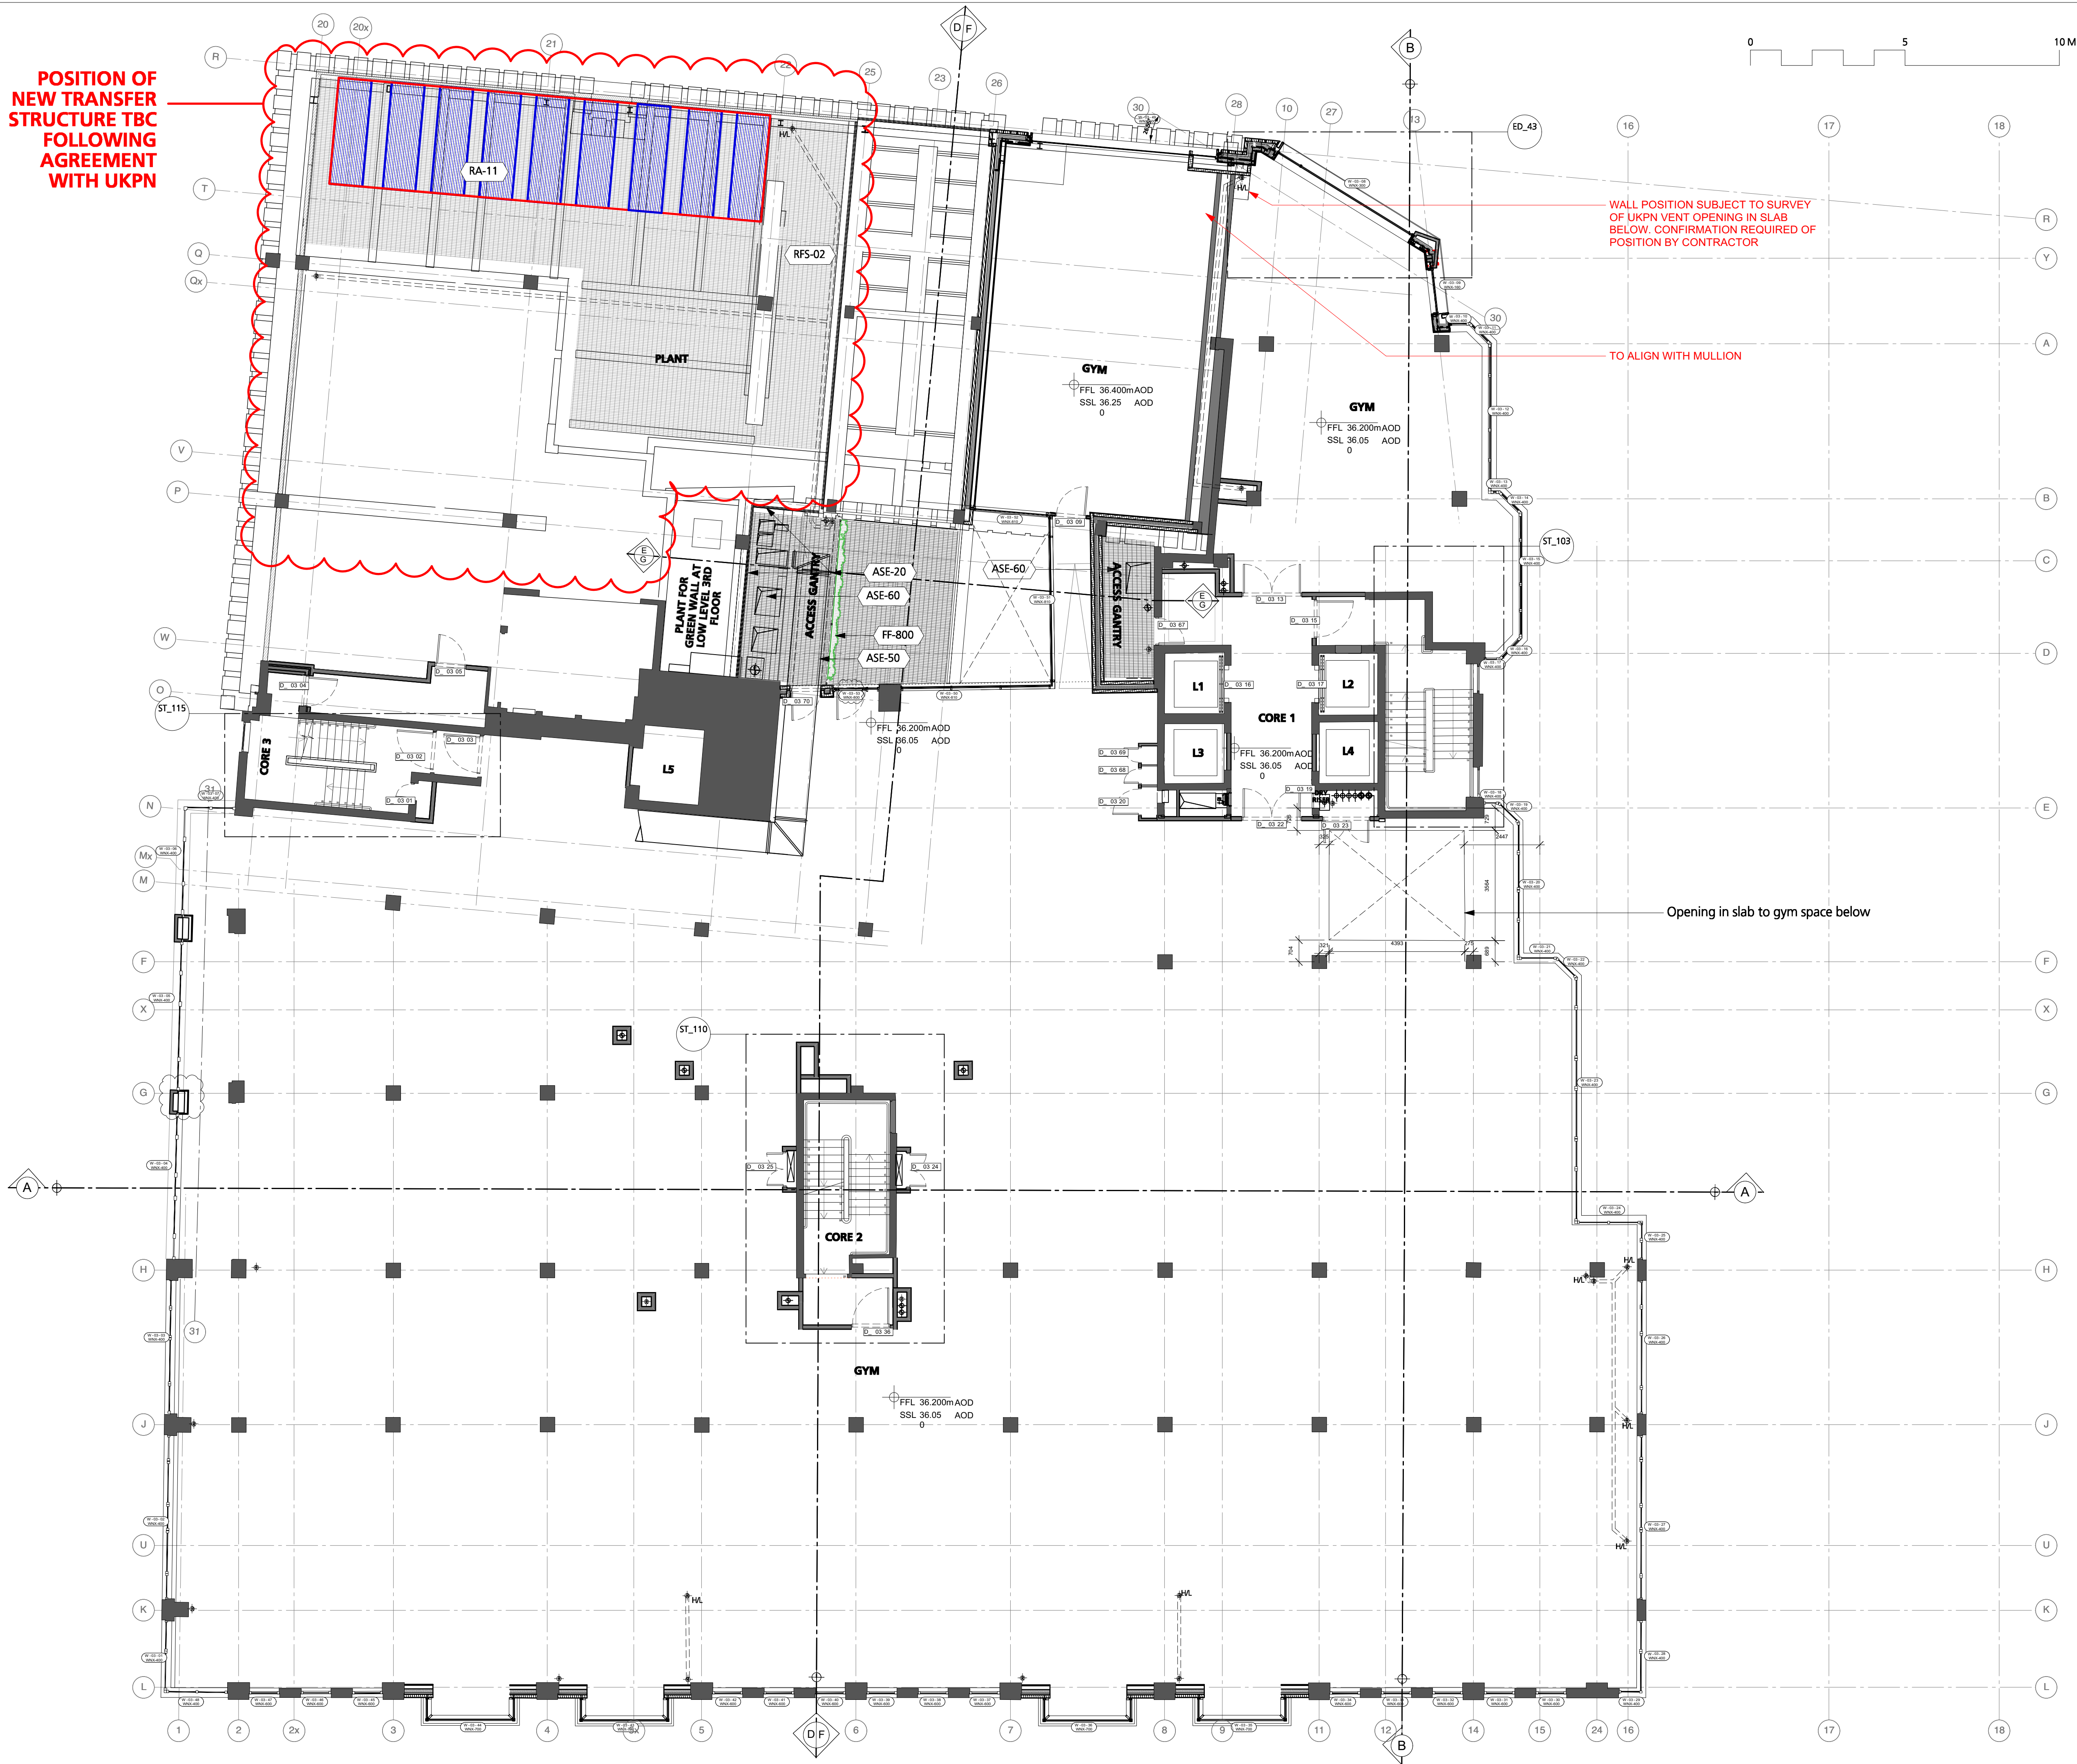

WALL POSITION SUBJECT TO SURVEY
OF UKPN VENT OPENING IN SLAB
BELOW. CONFIRMATION REQUIRED OF
POSITION BY CONTRACTOR

TO ALIGN WITH MULLION

Opening in slab to gym space below

GENERAL NOTES.

All dimensions to be checked on site prior to commencement of any works, and/or preparation of any shop drawings.

Sizes of and dimensions to any structural elements are indicative only. See structural engineers drawings for actual sizes / dimensions.

Sizes of and dimensions to any service elements are indicative only. See service engineers drawings for actual sizes and dimensions.

This drawing to be read in conjunction with all other Architect's drawings, specifications and other Consultants' information.

All proprietary systems shown on this drawing are to be installed strictly in accordance with the Manufacturers/Suppliers recommended details.

Any discrepancies between information shown on this drawing and any other contract information or manufacturers/suppliers recommendations is to be brought to the attention of the Architect

DO NOT SCALE FROM THIS DRAWING.

NOTES.

Key

- existing fabric
- existing fabric (unsurveyed)
- new fabric

Refer to BGY site investigation drawings for areas not fully surveyed and requiring further investigation and / or survey information.

Refer to WPP drawings and specification for MEP information.

Refer to R&P drawings and specification for structural information.

Refer to project T-Sheet for T-sheet references.

C8	Ganton St window adjacent to GL-G	17/06/20
C7	Tenant plan zones shown, UKPN vent detail	12/06/20
C6	Column positions amended	27/02/20
C5	As-built slab opening for tenant stair shown	09/01/20
C4	Lift numbering, pier sizes & wall position changed	12/12/19
C3	Plant decks, gantry ladders and balustrades	24/10/19
C2	Slab opening added, plant room grillage	03/10/19
C1	Issued for Construction	26/07/19
T7	Issued for Greenwall package	18/07/19
T6	Drawing glitch on North facade windows resolved	05/07/19
T5	Issued with Doors package	20/06/19
T4	Issued with Doors package	24/05/19
T3	Updated GA's	07/05/19
T2	Issued for 2nd Stage Tender	29/03/19
T1	Issued as 2nd Stage Tender	06/03/19

REVISION	DATE
Buckley Gray Yeoman	
Studio 4.04 The Tea Building 56 Shoreditch High Street London E1 6JJ T: 020 7033 9913 F: 020 7033 9914	
CLIENT	Shaftesbury Carnaby PLC
PROJECT	72 Broadwick St, W1F 9QZ
DRAWING	PROPOSED 3rd Floor Plan
SCALE	1:100 @ A1 (1:200 @ A3)
DATE	Feb. 2018
DWG No.	1076_GA_03
DRAWING STATUS	CONSTRUCTION