TOILETS & SUPPORT DETAILS

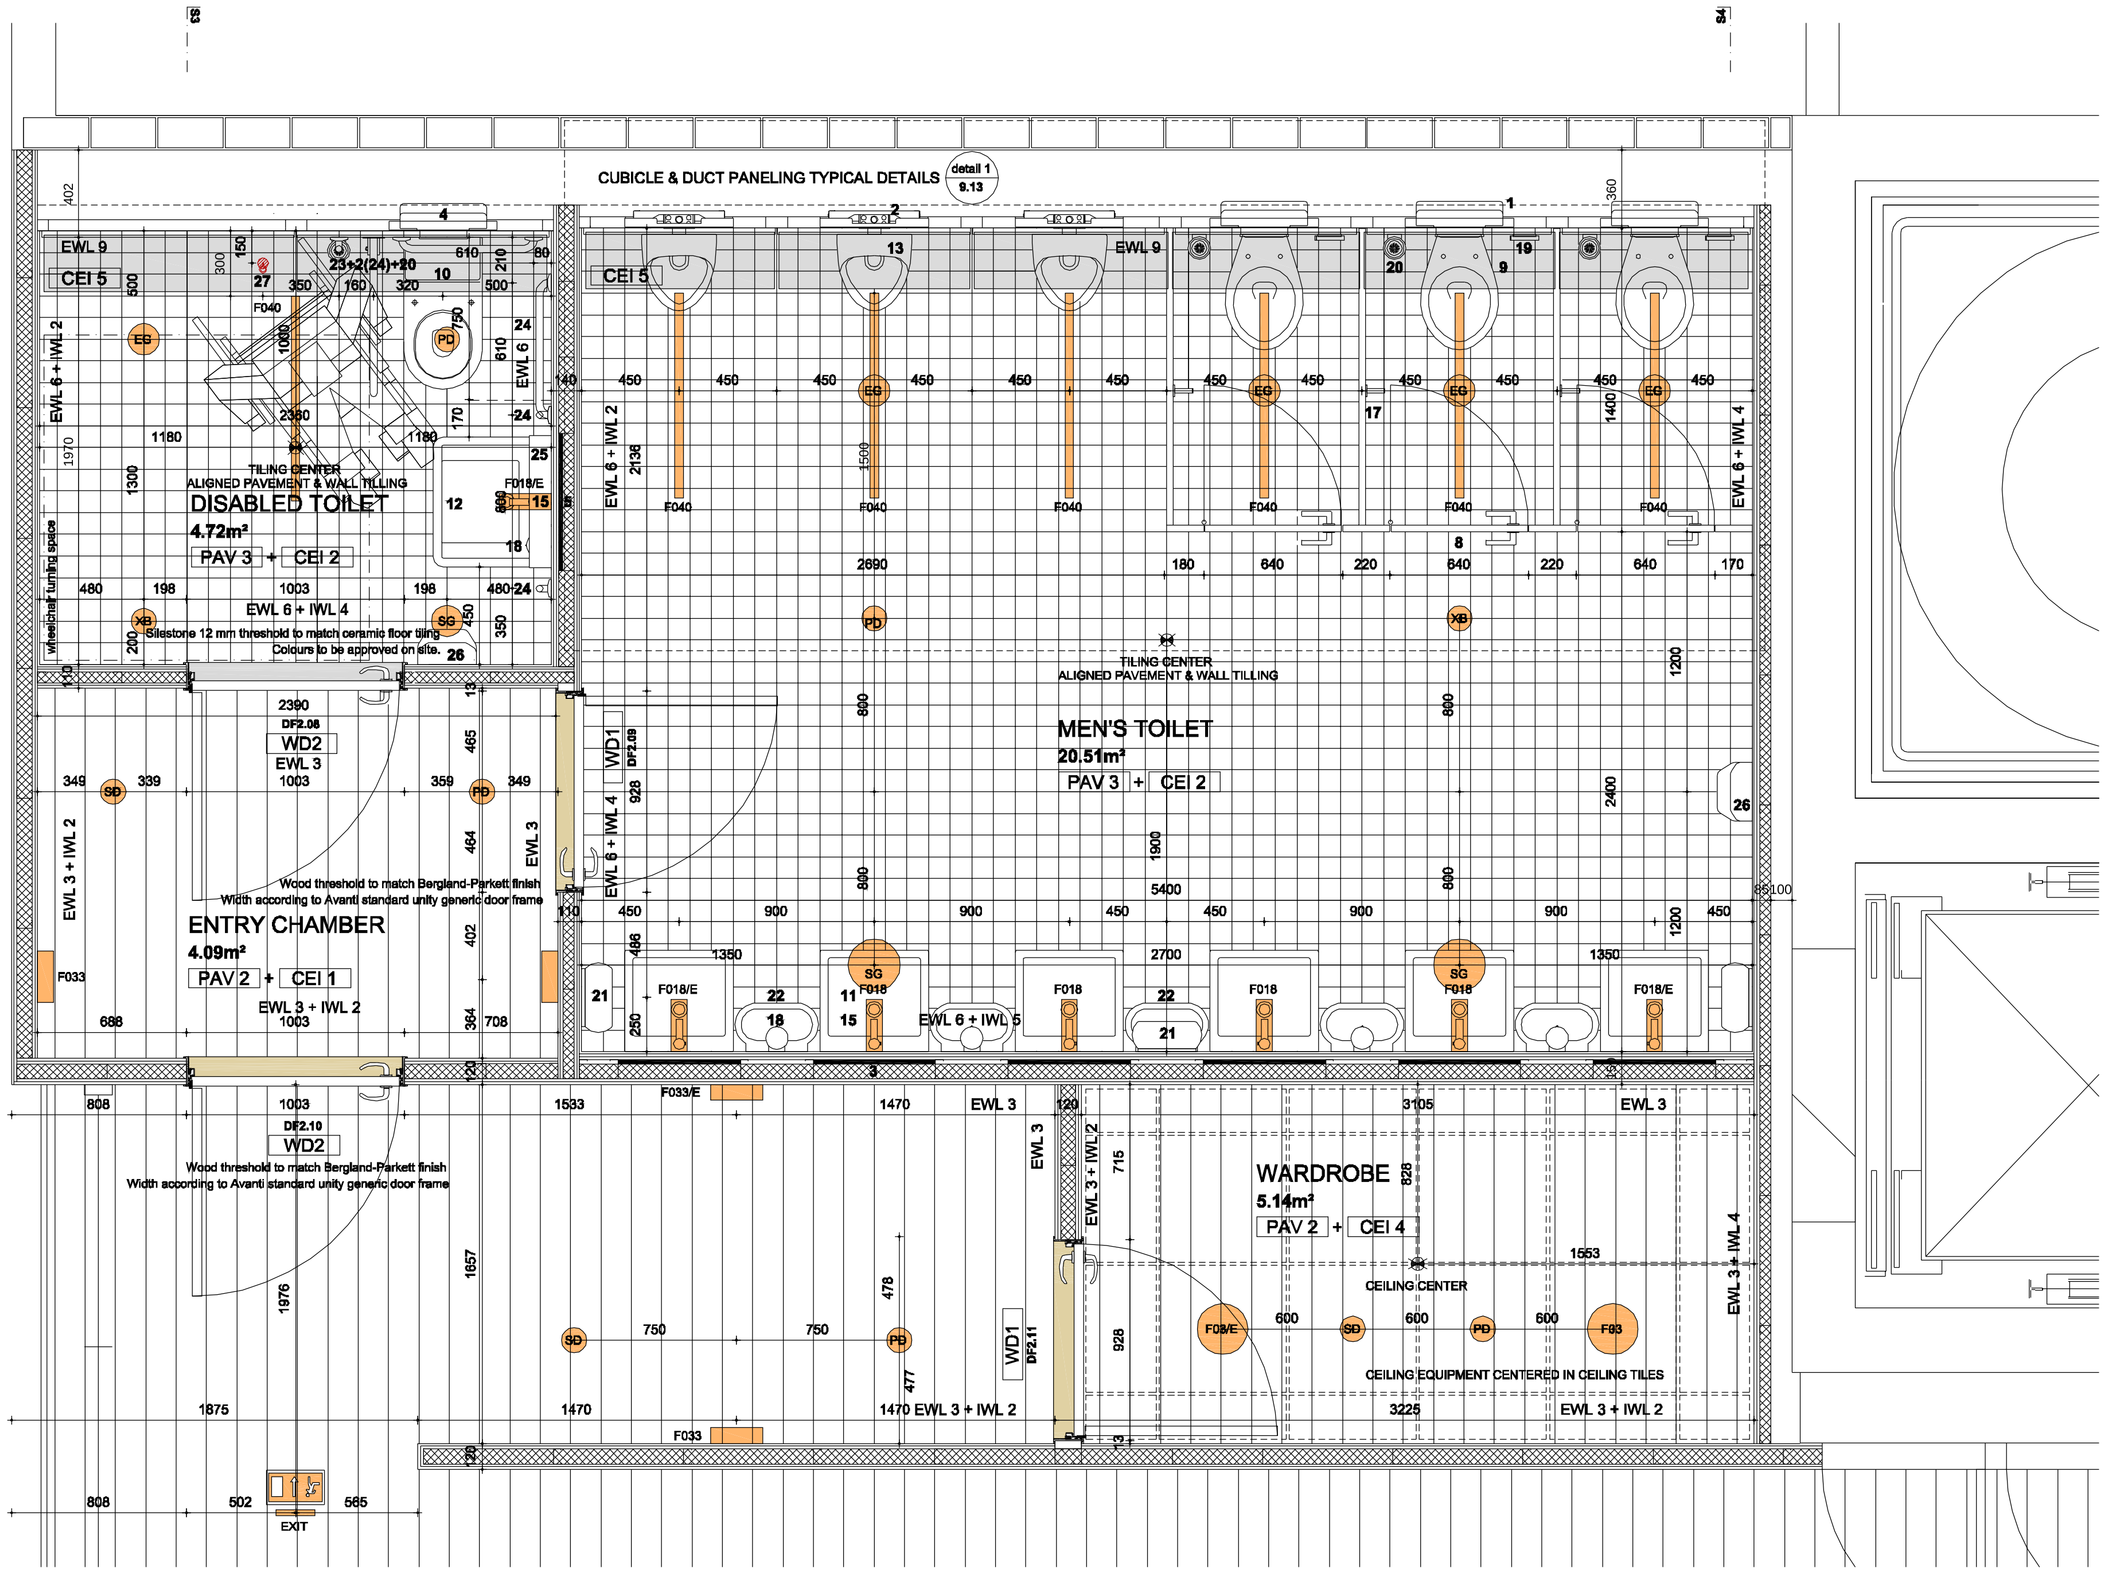

FLOOR PLAN DRAWING

General plumbing fixtures:

Wall hung installation systems

1. Geberit Duofix toilet frame with pre-wall brackets and extension set;
2. Geberit Duofix urinal frame;
3. Plywood pattress;
4. Geberit Duofix toilet frame for the disabled with pre-wall brackets and extension set;
5. Plywood pattress (installed to comply with design drawings measurements for disabled toilets);

Flush plates

6. Geberit Mambo stainless steel single flush toilet plate;
7. geberit mambo stainless steel hand operated pneumatic urinal control;

Toilets partition wall system

8. Kemmlit, cubicle system Noxx TR, white 9095;

Toilets

9. Duravit, wall mounted toilet Duraplus, Hornberg;
10. Duravit, disabled wall-mounted toilet, Starck 3 #220309;

Washbasins

11. Duravit, Vero;
12. Duravit, disabled washbasin,Starck 3 #030960;

Urinals

13. Duravit, Bill;
~~14. Duravit, Starck 3 Ceramic urinal partition;~~ (OMITTED)

Basin mixer tap & bottle trap

15. Keuco, Plan, single lever washbasin mixer without pop-waste, 54902;
15. (DISABLED TOILET) Keuco, Plan, single lever washbasin mixer without pop-waste, with extended lever, 54902;
16. Keuco, stainless steel finish bottle trap, 59906;

Accessories

17. Keuco, Plan, stainless steel hook with door buffer, 14911;
18. Keuco, Plan, stainless steel lotion dispenser, 14954;
19. Keuco, Plan, stainless steel toilet paper holder, 14962;
20. Keuco, Plan, stainless steel toilet brush set, 14964;
20. (DISABLED TOILET) Keuco, Plan, stainless steel toilet brush set with long handle, 34984;
21. Keuco, Plan, stainless steel paper towel dispenser, 14985;
22. Keuco, Plan, stainless steel wall mounted waste bin, 14988;
23. Mediclinics, stainless steel drop-down wall-mounted grab rail, BG0800CS;
24. Mediclinics, stainless steel grab rail, BR0600CS (610mm);
25. Bobrick, stainless steel mirror, B-145 2436;
26. Mediclinics, Mediflow, stainless steel hand dryer with thermostatic control system;
27. Disabled persons call system;

General pavements:

PAV 1

Solus Ceramics, AU.GMR.050 Anthracite Bright, 300x600 mm, R9 slip rating.

PAV 2

15 mm painted parquet, Bergland-parkett Ash Technograu Trend-Epoca 2400x140x15 mm, glued installation with SikaBond-T54.

PAV 3

Solus Ceramics, Altai 2CPD809, Off White, 100x100 mm.

General walls:

EWL 1

~~Glazed Balustrade, Laminated (extra clear low-iron) glass.~~ (OMITTED)

EWL 2

Acoustic laminated safety glass.

EWL 3

12.5 mm double layer of standard plasterboard painted white RAL 9010.

EWL 4

12.5 mm sound resistant double layer of plasterboard painted white RAL 9010.

EWL 5

12.5 mm moisture resisting double layer of plasterboard painted white RAL 9010.

EWL 6

Solus Ceramics, Altai 2CPD809, Off White, 100x100 mm.
12.5 mm moisture resisting double layer of plasterboard.

EWL 7

Wall coverings to define.
12.5 mm sound resistant double layer of plasterboard.

EWL 8

12.5 mm sound resistant double layer of plasterboard.

EWL 9

30 mm Kemmlit duct panel, Noxx TR, white 9095.

IWL 1

70 mm Lightweight metal stud at 600 mm centers.

IWL 2

70 mm Lightweight metal stud at 600 mm centers.
67mm Acoustic partition slab between studs.

IWL 3

50 mm Lightweight metal stud at 600 mm centers.

IWL 4

50 mm Lightweight metal stud at 600 mm centers.
47mm Acoustic partition slab between studs.

IWL5

90 mm Lightweight metal stud at 600 mm centers.
67mm Acoustic partition slab between studs.

General ceilings:

CEI 1 - 2ND FLOOR

Suspended ceilings system.
Standard plasterboard painted white RAL 9010.

CEI 1 - 3RD FLOOR

Suspended ceilings system.
12.5 mm double layer of standard plasterboard painted white RAL 9010.

CEI 2

Suspended ceilings system.
Moisture resisting plasterboard painted white RAL 9010.

CEI 3

Suspended ceilings system.
Plasterboard painted white RAL 9010 (Sound resistant double layers of 12.5 mm each side).
100 mm Acoustic partition slab between light steel joists.

CEI 4

Ceiling tiles 600x800x15 mm, Rockfon Pacific® range, E edge detail.
Rockfon White pre-finished.

CEI 5

Metal suspended ceiling 900x250x30 mm, SAS International.
Polyester powder coated in standard range White RAL 9010.

Separation between ceramic tiles and parquet flooring with Schluter - SCHIENE, stainless steel.
Movement joints with Schluter ® - DILEX EKSN, movement zone on synthetic rubber.
All visible steel plates coated in white RAL 9010.

USE THIS DRAWINGS FOR CEILING EQUIPMENT SETTING OUT

REVISION	DATE	DESCRIPTION
D	19.11.08	UPDATED REFERENCES TO GENERAL PLUMBING FIXTURES
		UPDATED DIMENSIONS TO CUBICLE SYSTEM PARTITIONING

CONSTRUCTION

AUDI WEST LONDON LONDON, UK	DATE: NOV 2008 SCALE: 1:20@A1	9.4
2ND FLOOR TOILETS - MEN'S TOILET FLOOR PLAN DRAWING	CONSTRUCTION DRAWINGS	ASSIST.: FERNANDO CARLOTA
ATMB13 arquitectos lda R. Ricardo Espírito Santo, 9, cv. dta., 1200 790 Lisboa, tel.: 21 3931244, fax 21 3931249		RESP.: MIGUEL BELEZA

REPRODUÇÃO TOTAL OU PARCIAL RESERVADA À ENTIDADE PROPRIETÁRIA PARA OS FINS E NOS TERMOS CONTRATUAIS. PROPRIEDADE INTELECTUAL E DIREITOS DE AUTOR DE ATMB13, ARQUITECTOS, LDA. DECRETO LEI 63 / 85 (14 MARÇO)

Do not Scale. Used figured dimensions only. All dimensions to be checked on site.

All drawings to be read in conjunction with the Engineers' drawings. Any discrepencies between consultants drawings to be reported to the Architect before any work commences.